SECOND FLOOR PLAN

SQ. F.T = 871

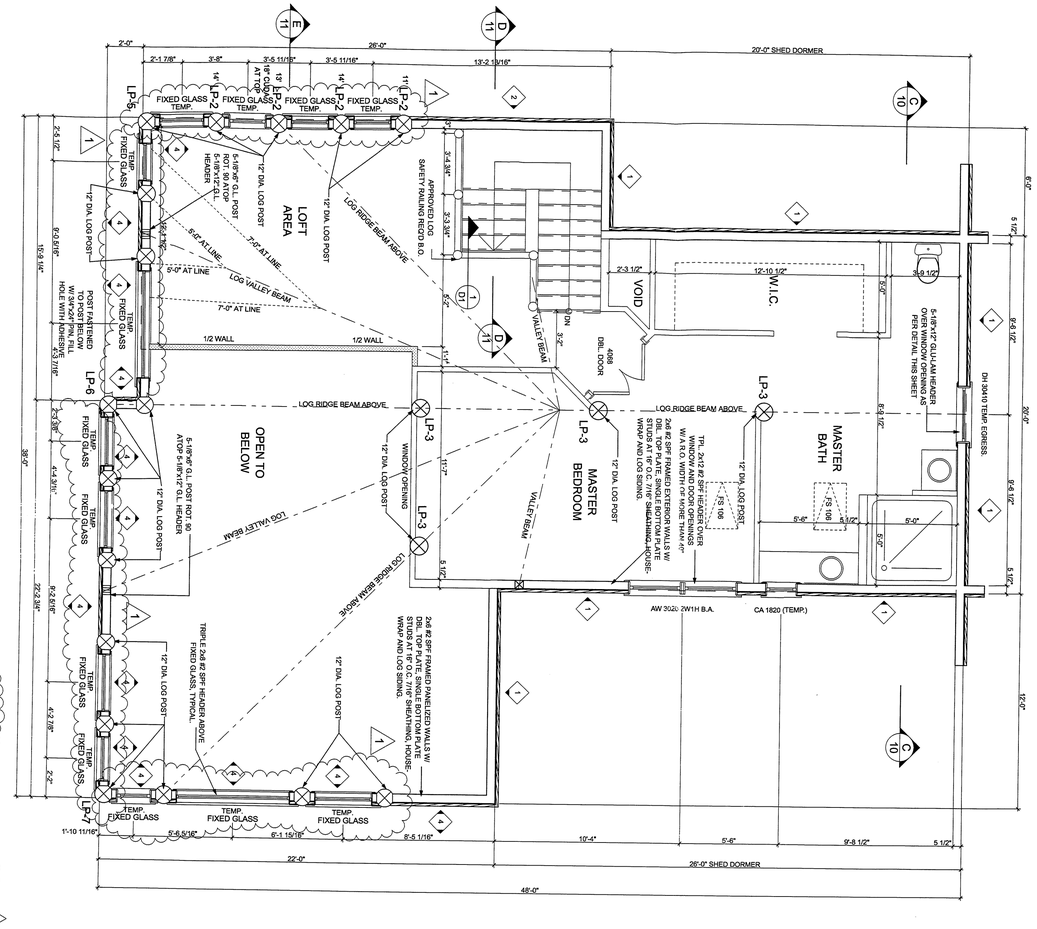

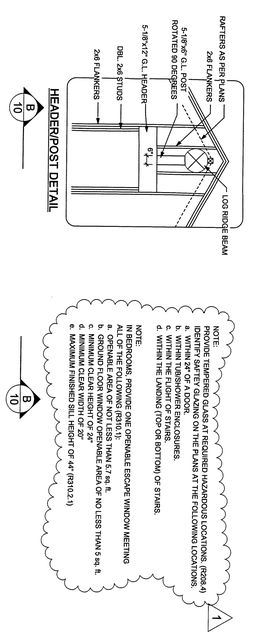

NOTE:
ALL HOLD DOWN HARDWARE MUST BE SECURED IN PLACE PRIOR TO FOUNDATION INSPECTION.

APPROVED

AUG 30 2007

REVISED BY

4 SEASONS ENGINEERING, INC.
619 S. CHASE ST.
PORT ANGELES, WA

No.	REVISIONS	DATE
6		
5		
4		
3		
2		
1	PLAN CHECK # 1	8/27/07

0 1" 2" 3"

THE ORIGINAL Lincoln Logs® LTD.
5 RIVERSIDE DRIVE, P.O. BOX 135
CHESTERTOWN, NEW YORK 12817
PHONE: (518) 494-5500 FAX: (518) 494-7495

COPYRIGHT © 2007 LINCOLN LOGS LTD.

Status	Final Drawing
Drafter	M. Rice
Checked	
Scale	1/4"= 1'-0"
Date	3-20-07
Order No.	0728004-630
Cad File	Pfeifer.pln

CUSTOMER

Pfeifer Residence

3317 Green Mountain Road
Kalama, WA
Cowlitz County

SHEET TITLE

Second Floor Plan

Drawing No.

3

SHEET